NOTE: ALL LOCATIONS OF EXISTING UTILITIES SHOWN ON THE PLAN HAVE BEEN DEVELOPED FROM EXISTING UTILITY RECORDS AND/OR ABOVE GROUND EXAMINATION OF THE SITE. COMPLETENESS OR ACCURACY OF LOCATION AND DEPTH OF UNDERGROUND UTILITIES OR STRUCTURES CANNOT BE GUARANTEED. CONTRACTOR MUST VERIFY LOCATION AND DEPTH OF ALL UNDERGROUND UTILITIES AND FACILITIES BEFORE START OF WORK.

PROPERTY LINE LOCATIONS TAKEN FROM PLAN FOR ROBERT C. WIGGINS DATED 12-12-84 BY CHESTER VALLEY ENGINEERS, INC., PAOLI, PA.

TOPO AND SPOT ELEVATIONS ARE FROM FIELD SURVEY BY YERKES ASSOC. INC.

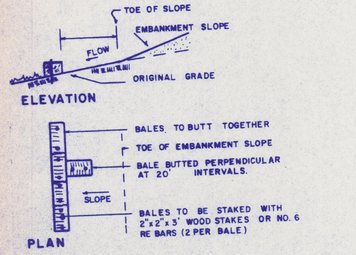

1 STRAWBALE BARRIERS
NOT TO SCALE

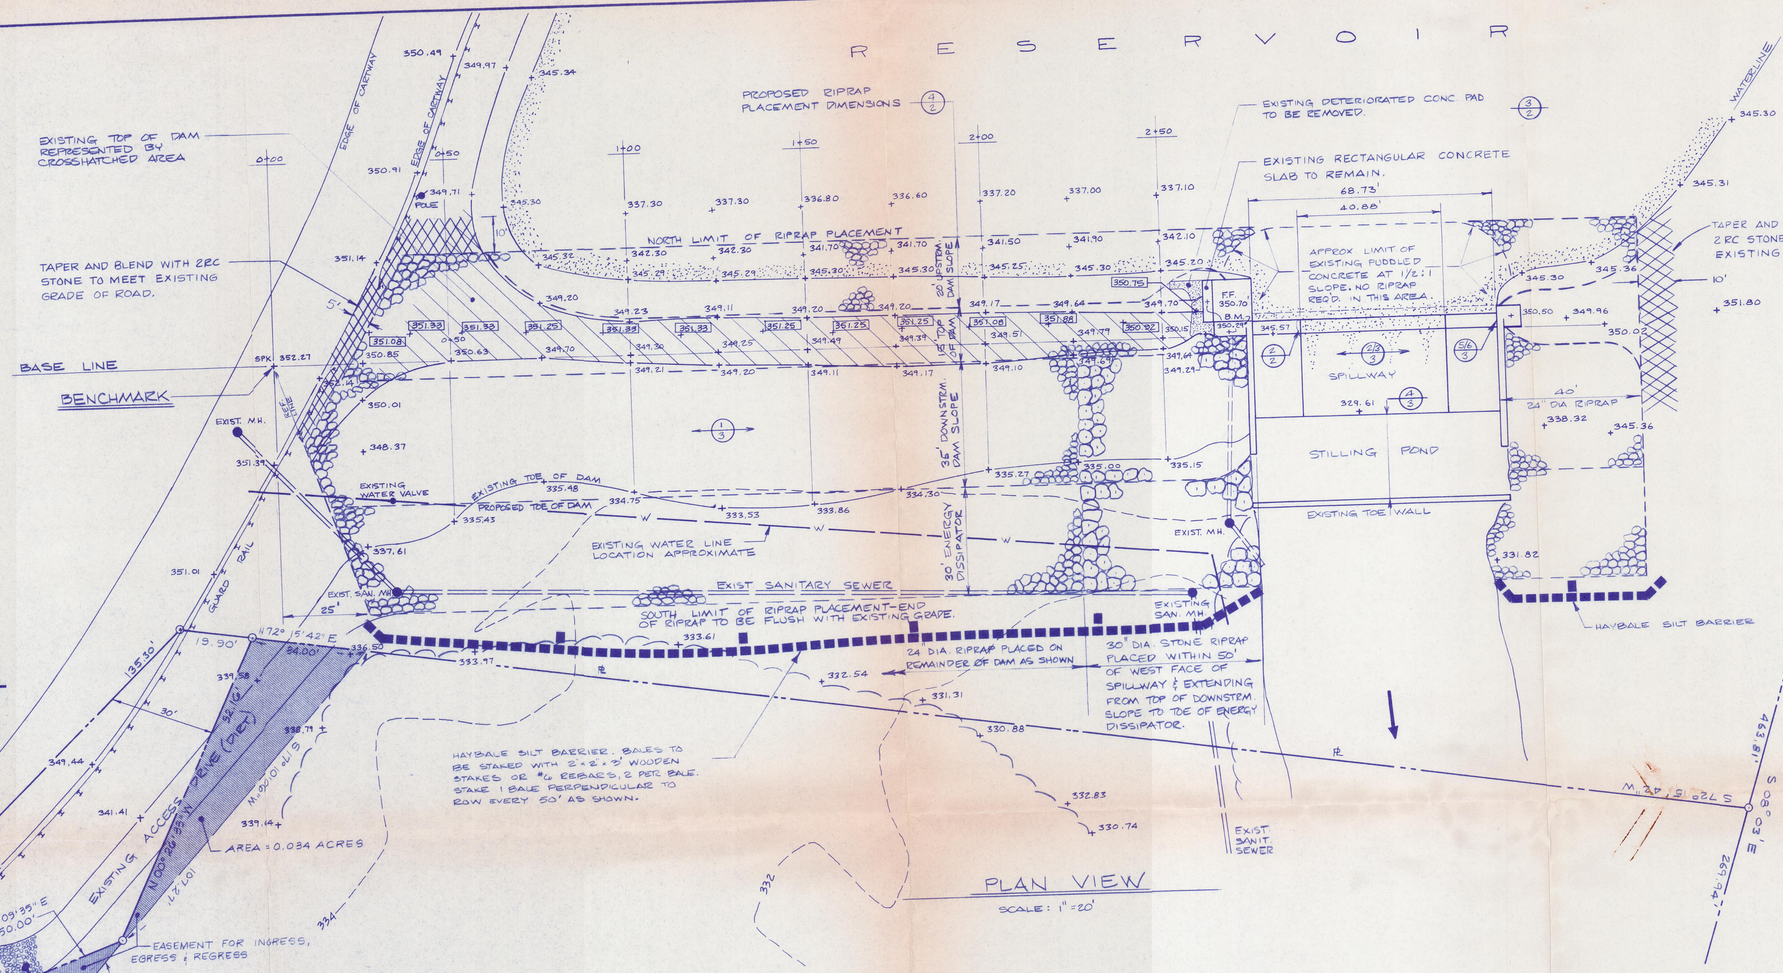

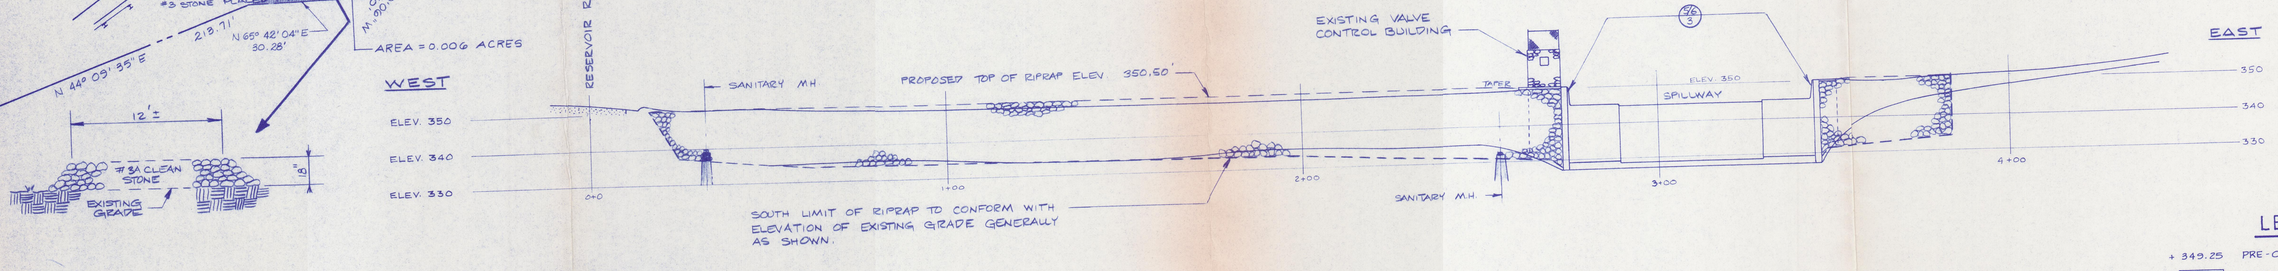

2 TIRE TREAD CLEANER
NOT TO SCALE

ISSUED
DEC 16 1986
YERKES ASSOC., INC.

LEGEND
+ 349.25 PRE-CONSTRUCTION ELEVATION
+ 351.25 POST-CONSTRUCTION ELEVATION (AS-BUILT)

SHEET 1 OF 4

Order # W 6601
Drawn By AJG
Checked By
Approved By

YERKES ASSOCIATES, INC.
CONSULTING ENGINEERS LANDSCAPE ARCHITECTS
SITE PLANNERS ARCHITECTS SURVEYORS

PLAN OF
REPAIR WORK FOR MILLTOWN DAM
EAST GOSHEN TOWNSHIP CHESTER COUNTY, PENNSYLVANIA

REVISIONS

AS-BUILT SITE PLAN

DATE: 1-30-85
53-74
SCALE: AS NOTED

5133